


PROPOSED LICENSED AREAS

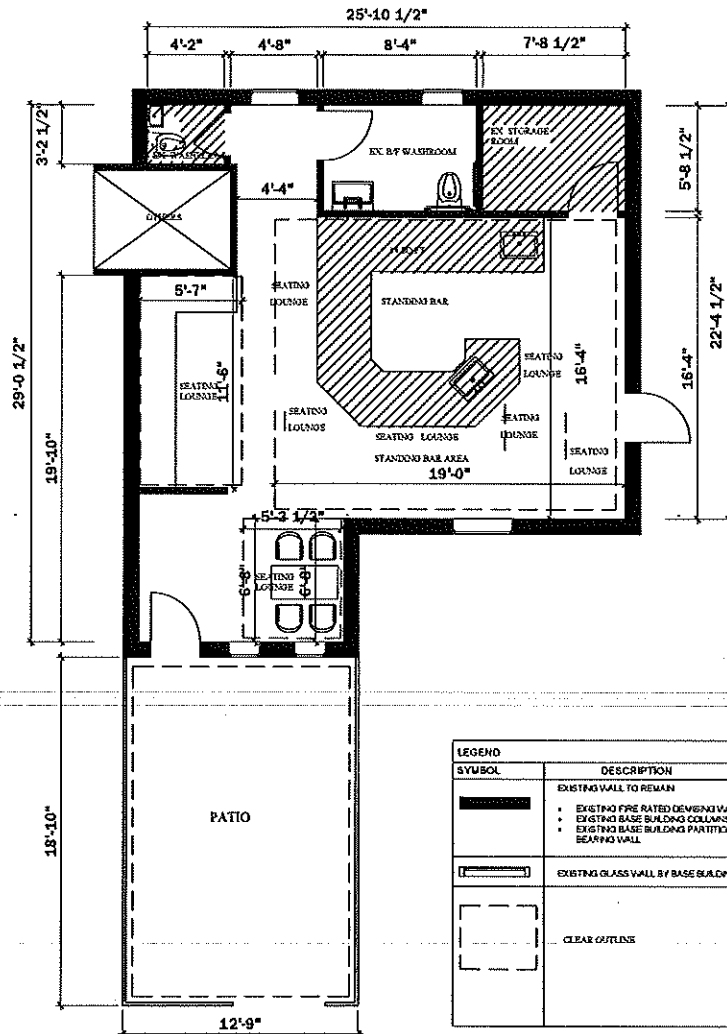

2 AS-BUILT FLOOR PLAN

Sheet Title		AS-BUILT FLOOR PLAN		ALL DRAWINGS, SPECIFICATIONS AND RELATED DOCUMENTS ARE THE COPYRIGHT PROPERTY OF THE ARCHITECT AND MUST BE RETURNED UPON REQUEST. REPRODUCTION OF DRINGS, SPECIFICATIONS AND RELATED DOCUMENTS IN PERMISSION OF THE ARCHITECT. DO NOT SCALE DRAWINGS. CONTRACTOR MUST CHECK & VERIFY ALL DIMENSION ON SITE. THIS DRAWING IS NOT TO BE USED FOR CONSTRUCTION UNTIL SIGNED BY THE ARCHITECT.		LICENSED PROFESSIONAL ENGINEER D. Q. XU 100078635 2023-12-07 PROVINCE OF ONTARIO		AS-BUILT FLOOR PLAN		
Client				DO NOT SCALE DRAWINGS.		Scale	Drawn by	Project No.		
Project		COMMERCIAL BUILDING AS-BUILT DRAWING 142 Main St Unionville, ON L3R 2G5		CONTRACTOR MUST CHECK & VERIFY ALL DIMENSION ON SITE.		1/16" = 1'-0"	XX	2023-58		
				THIS DRAWING IS NOT TO BE USED FOR CONSTRUCTION UNTIL SIGNED BY THE ARCHITECT.		Date	Checked by	Drawing No.		
						2023-12-07	OK	1 of 1		