Ontario

Return completed form to:
Alcohol and Gaming Commission of Ontario
90 SHEPPARD AVE E
SUITE 200
TORONTO ON M2N 0A4

Remplir et retourner cette formule à :
Commission des alcools et des jeux de l'Ontario
90 AV SHEPPARD E
BUREAU 200
TORONTO ON M2N 0A4

Municipal Information / Renseignements municipaux

The information requested below is required in support of all applications for a **new** liquor licence or outdoor areas being added to an **existing** liquor licence.

Les renseignements sont recueillis conjointement à toute demande de **nouveau** permis d'alcool ou d'ajout de zones de plein air à un permis d'alcool **existant**.

Section 1 - Application Details / Section 1 - Détails de la demande

Establishment name / Nom de l'établissement: Gyubee Japanese BBQ

Establishment tel. no. / N° de tél. de l'établissement:

Contact name / Nom de la personne à contacter: Shanjun Qu

Contact's tel. no. / N° de tél. de la personne à contacter:

Exact location of establishment (not mailing address) / Emplacement exact de l'établissement (non l'adresse postale)

Street Number / Numéro	Street Name / Nom de rue	Street Type / Genre de rue	Direction / Orientation de rue	Suite/Floor/Apt. / Bureau/étage/app.
7100	Woodbine	Ave		100

Lot/Concession/Route / Lot/concession/route rurale	City/ Town/Municipality / Ville/village/municipalité	Postal Code / Code postal
	Markham	L3R5J2

Does the application for a liquor licence include: / La demande de permis d'alcool porte-t-elle entre autres sur :

☑ indoor areas / des zones intérieures ☐ outdoor areas / des zones de plein air

Section 2 - Municipal Clerk's official notice of application for a liquor licence in your municipality / Section 2 - Avis officiel de demande de permis d'alcool dans votre municipalité à l'intention du (de la) secrétaire municipal(e)

Municipal Clerk: please confirm the "wet/damp/dry" status below.

Secrétaire municipal(e) : Confirmer le statut de la région ci-dessous.

Name of village, town, township or city where taxes are paid / Nom du village, de la ville ou du canton à qui les impôts sont versés :
(If the area where the establishment is located was annexed or amalgamated, provide the name of the Village, Town, Township or City was known as)
(Si la région où se trouve l'établissement a été annexée ou fusionnée, nom sous lequel le village, la ville ou le canton était connu)

Is the area where the establishment is located: / La vente de boissons alcooliques est-elle autorisée dans la région où se trouve l'établissement?

☐ Wet (for spirits, beer, wine) / Oui (spiritueux, bière, vin) ☐ Damp (for beer and wine only) / Oui (bière et vin seulement) ☐ Dry / Non

Note:

Specific concerns regarding zoning or non-compliance with bylaws must be clearly outlined **in a separate submission or letter within 30 days of this notification.**

Remarque :

Toute préoccupation concernant le zonage ou la non-conformité aux règlements municipaux doit être clairement décrite **dans un document distinct ou une lettre, à l'intérieur d'une période de 30 jours après la date du présent avis.**

Signature of municipal official / Signature du (de la) représentant(e) municipal(e)

Title / Poste

Address of municipal office / Adresse du bureau municipal

Date

MARKHAM

CITY OF MARKHAM

LIQUOR LICENCE QUESTIONNAIRE

To enable our evaluation of your Liquor License application, the following information is required.

Please return the completed form to the Clerk's Department.

1. What Type of restaurant is proposed?
   ☐ Family ☐ Roadhouse ☐ Sports Bar ☒ Fine Dining ☐ Take Out ☐ Cafe

2. a. What type of Food will be served: Varied menu ☐ Specialty ☐ Snacks
   b. ☒ *Menu attached (Please note, a copy of the menu is required with all applications)*

3. What entertainment or amusements will be provided?
   ☐ Karaoke ☐ Live entertainment ☐ Casino ☐ Off-tract betting ☐ Arcade ☒

4. *a. The maximum seating capacity will be* ~~168~~ 170 *persons.*
   b. Where the restaurant is existing, the previous seating capacity was 170 *persons.*

5. *a. Was this premises previously used as a restaurant?*
   ☒ *Yes* ☐ *No (Note: if the answer to this question is no, a building permit will be required)*
   b. If this premise was previously used as a restaurant, is any construction or alteration purposed?
   ☒ *Yes* ☐ *No (If the answer to this question is yes, a building permit will be required)*

6. *Has a building permit been applied for or obtained in connection with these premises?*
   ☐ *Yes* *Permit no.* 15 170902 000 01 AL
   ☐ *No* *Provide 1 copy of the floor plan showing the dimensioned floor plan showing the dimensioned floor layout, floor areas to be licenced, seating arrangements, washrooms (show fixtures) and exits.*

7. *Does the building on the premises have a fire alarm system?* *Yes* ☒ *No* ☐

8. *Were the premises previously licensed?* *Yes* ☒ *No* ☐

9. *Is the liquor licence application for an expansion of the existing operations?* *Yes* ☐ *No* ☐
   (If yes, Please provide details on a separate page)

10. *What is the nearest major intersection to the proposed locations?* Innisbine & Steeles

11. *What is the distance to the nearest residential area?* > 21 m

12. *a) Your name (Please Print)* Shanjun Qu
    b) Contact Telephone No. *Bus:* ---- *Res:* 905 325 2650
    c) The restaurant's name Gyukee Japanese BBQ

Updated: July 2012

Menu

Soup & Salad
1. House Salad
2. Miso soup

Appetizer:
1. Edamame
2. Deep Fried Dumplings
3. Takoyaki
4. Calamari

BBQ:
1. Beef Short Ribs
2. Beef Steak
3. Beef Tongue
4. Chicken
5. Pork Belly
6. Shrimp
7. Scallop
8. Zucchini
9. Eggplant
10. Mushroom
11. Onion

Rice & Noodles:
1. Steamed Rice
2. Udon

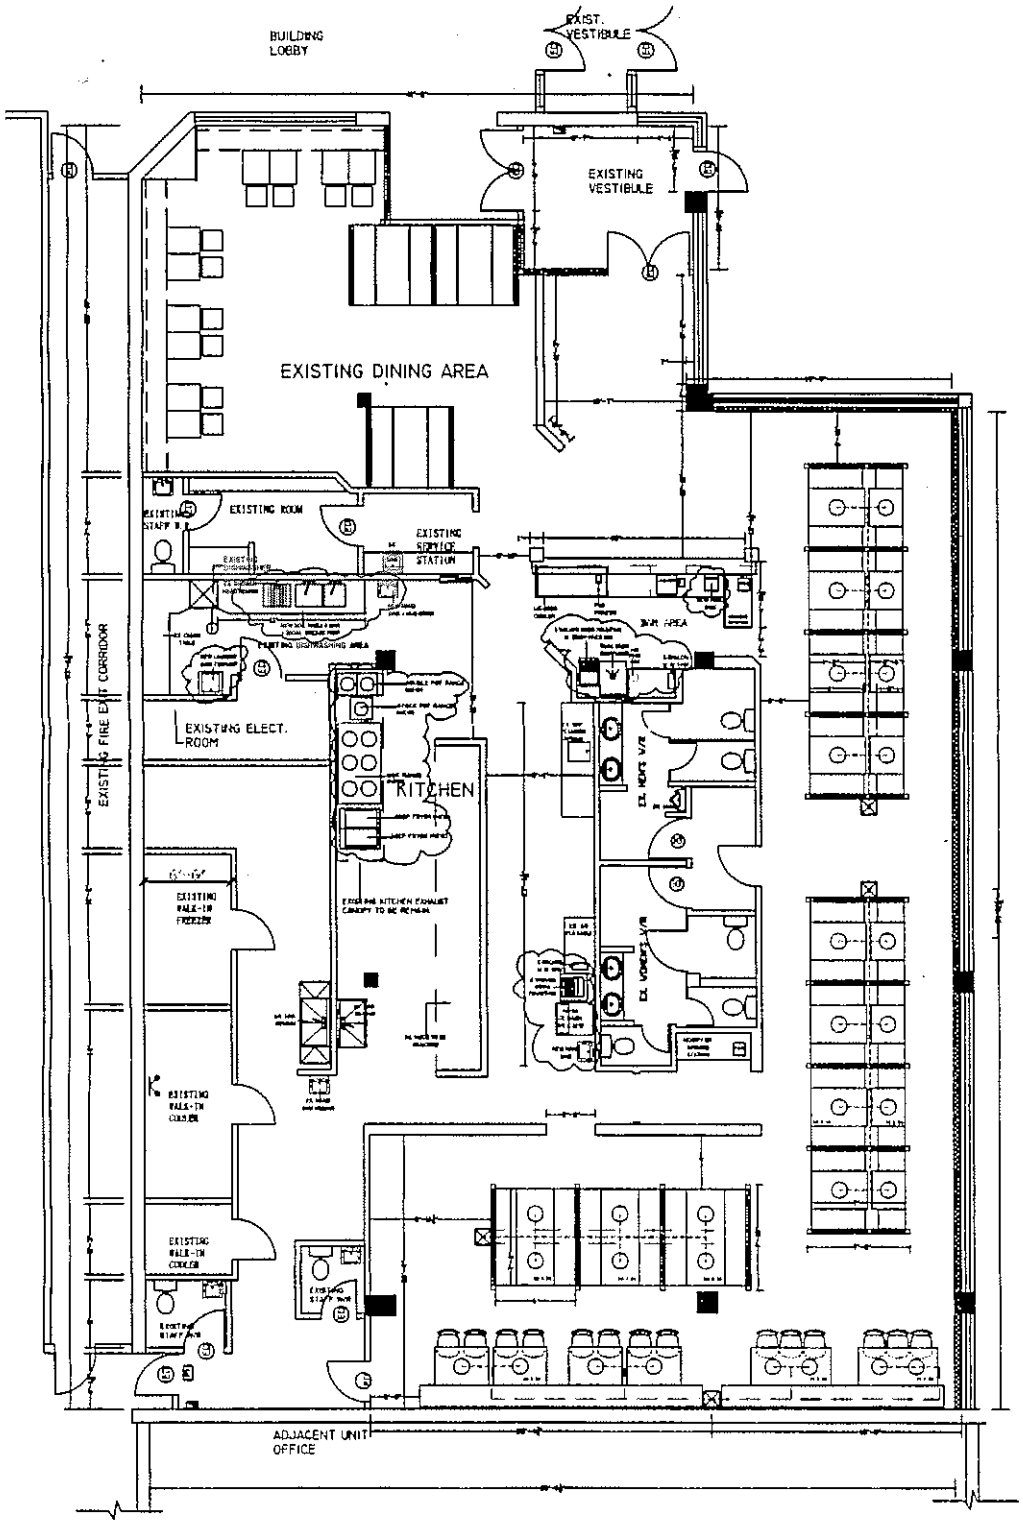

Global

Construction

107-110 Silver Star Blvd.
Scarborough, Ontario M1V 5A2
T. 416-321-0998
F. 416-321-5657
globalconst@bellnet.ca

Project

GYUBEE RESTAURANT

7100 WOODBINE AVE.
UNIT 100

Title

SPACE PLAN

Scale: NIL

Date: JAN.18.2016

Drawn by: NC

Dwg. No. A1

Rev.

RESTAURANT:
CAPACITY: 168 PERSONS

STAFF: 10 PERSONS/ SHIFT