

Municipal Information Renseignements municipaux

Return completed form to:
Alcohol and Gaming Commission of Ontario
90 Sheppard Avenue, East, Suite 200
Toronto ON M2N 0A4

Remplir et retourner cette formule à :
Commission des alcools et des jeux de l'Ontario
90, avenue Sheppard Est Bureau 200
Toronto ON M2N 0A4



The information requested below is required in support of all applications for a **new** liquor licence or outdoor areas being added to an **existing** liquor licence.

Les renseignements sont recueillis conjointement à toute demande de **nouveau** permis d'alcool ou d'ajout de zones de plein air à un permis d'alcool existant.

Section 1 - Application Details

Section 1 - Détails de la demande

Establishment name/Nom de l'établissement

FUJIYA JAPANESE RESTAURANT

Establishment tel. no./ N° de tél. de l'établissement

905-513 9889

Contact name/Nom de la personne à contacter

TENG, SHIWEI

Contact's tel. no./ N° de tél. de la personne à contacter

905-513 9889

Exact location of establishment (not mailing address - street number and name, city or lot no., concession and township)

Emplacement exact de l'établissement (non l'adresse postale - numéro et nom de la rue, ville ou numéro de lot, concession et canton)

3636 STEELES AVENUE EAST, UNITS 121, 122, 123, MARKHAM, ON L3R 1K9

Does the application for a liquor licence include:/La demande de permis d'alcool porte-t-elle entre autres sur :

☒ indoor areas/des zones intérieures ☐ outdoor areas/des zones de plein air

Section 2 - Municipal Clerk's official notice of application for a liquor licence in your municipality

Section 2 - Avis officiel de demande de permis d'alcool dans votre municipalité à l'intention du (de la) secrétaire municipal(e)

Municipal Clerk - please confirm the "wet/damp/dry" status below.

Secrétaire municipal(e) : Confirmer le statut de la région ci-dessous.

Name of village, town, township or city where taxes are paid/Nom du village, de la ville ou du canton à qui les impôts sont versés :

(If the area where the establishment is located was annexed or amalgamated, provide the name of the Village, Town, Township or City as known as)

(Si la région où se trouve l'établissement a été annexée ou fusionnée, nom sous lequel le village, la ville ou le canton était connu)

Is the area where the establishment is located:/ La vente de boissons alcooliques est-elle autorisée dans la région où se trouve l'établissement?

☐ Wet (for spirits, beer, wine)/Oui (spiritueux, bière, vin) ☐ Damp (for beer and wine only)/Oui (bière et vin seulement) ☐ Dry/Non

Note:

Specify concerns regarding zoning, non-compliance with bylaws, or general objections to the application by council or elected municipal representatives, must be clearly outlined, **in a separate submission or letter within 30 days of this notification.**

Remarque :

Toute question particulière concernant le zonage, la non-conformité aux règlements municipaux ou toute objection générale relative à la demande de la part de membres du conseil ou de représentants municipaux élus doit être décrite clairement **dans un document distinct ou une lettre à l'intérieur d'une période de 30 jours après la remise du présent avis.**

Signature of municipal official/Signature du (de la) représentant(e) municipal(e)

Title/Poste

Address of municipal office/Adresse du bureau municipal

Date



Town of Markham

LIQUOR LICENCE QUESTIONNAIRE

*To enable our evaluation of your liquor licence application, the following information is required.
Please return the completed form to the Clerk's Department.*

1. What type of restaurant is proposed?
☒ Family ☐ Roadhouse ☐ Sports Bar ☐ Fine Dining ☐ Take Out ☐ Café

2. a) What type of Food will be served: Varied menu ☒ Specialty ☐ Snacks ☐
 b) ☒ Menu attached (Please note, a copy of the menu is required with all applications)

3. What entertainment or amusements will be provided?
☐ Karaoke ☐ Live entertainment ☐ Casino ☐ Off-track betting ☐ Arcade ☒ NO

4. a) The maximum seating capacity will be 70 persons.
 b) Where the restaurant is existing, the previous seating capacity was 70 persons.

5. a) Was this premises previously used as a restaurant?
☒ Yes ☐ No (Note: If the answer to this question is no, a building permit will be required)
 b) If this premises was previously used as a restaurant, is any construction or alteration proposed?
☐ Yes ☒ No (If the answer to this question is yes, a building permit will be required)

6. Has a building permit been applied for or obtained in connection with these premises?
☐ Yes Permit No. _____
☒ No Provide 2 copies of the floor plan showing the dimensioned floor layout, floor areas to be licenced, seating arrangements. Washrooms(show fixtures) and exits.

7. Does the building on the premises have a fire alarm system? ☒ Yes ☐ No

8. Were the premises previously licenced? ☒ Yes ☐ No

9. Is the liquor licence application for an expansion of the existing operations? ☐ Yes ☒ No
 (If yes, please provide details on a separate page)

10. What is the nearest major intersection to the proposed location? Steeles / Pharmacy

11. What is the distance to the nearest residential area? 100 Meters

12. a) Your name (Please print) Jolene Chen b) Contact Telephone No.
 Bus: 416-646-7881 c) The restaurant's name
 Res: _____ FUTUYA JAPANESE
RESTAURANT

FOR OFFICIAL USE ONLY

Inspected by By-law Enforcement Date: _____

Comments: _____

☐ Approved ☐ Not approved


LANDLORD'S A/C UNIT ON ROOF TO REMAIN
 TORK MODEL = D-3-CR 060H 955 BDC
 H.P. OUTPUT = 59,000 BTU
 C.T.P. CAPACITY = 5.5 TONS
 AIR FLOW = 2,000 CFM @ 0.5" ESP
 CONTRACTOR SHALL RECALIBRATION REFERENCE
 ANY FAULTY PARTS AS REQUIRED.
 INCREASE FRESH AIR INTAKE TO 30% FROM 10%
 FOR A NEW F/A OF 600 CFM.

RY OF FRESH AIR/ EXHAUST AIR
 FLOW RATE = 40 X 20 = 800 CFM
 (FRESH EXHAUST)
 UP FROM NEW = 200 CFM
 UP FROM OLD = 600 CFM
 UP FROM NEW = 200 CFM
 UP FROM OLD = 600 CFM

NOTES:

1. Air duct systems shall be installed in accordance with the Ontario Building Code as amended.
2. All supply air branches to have balancing dampers.
3. Ceiling spaces used as plenums shall be constructed in accordance with the Ontario Building Code as amended.

- 2005

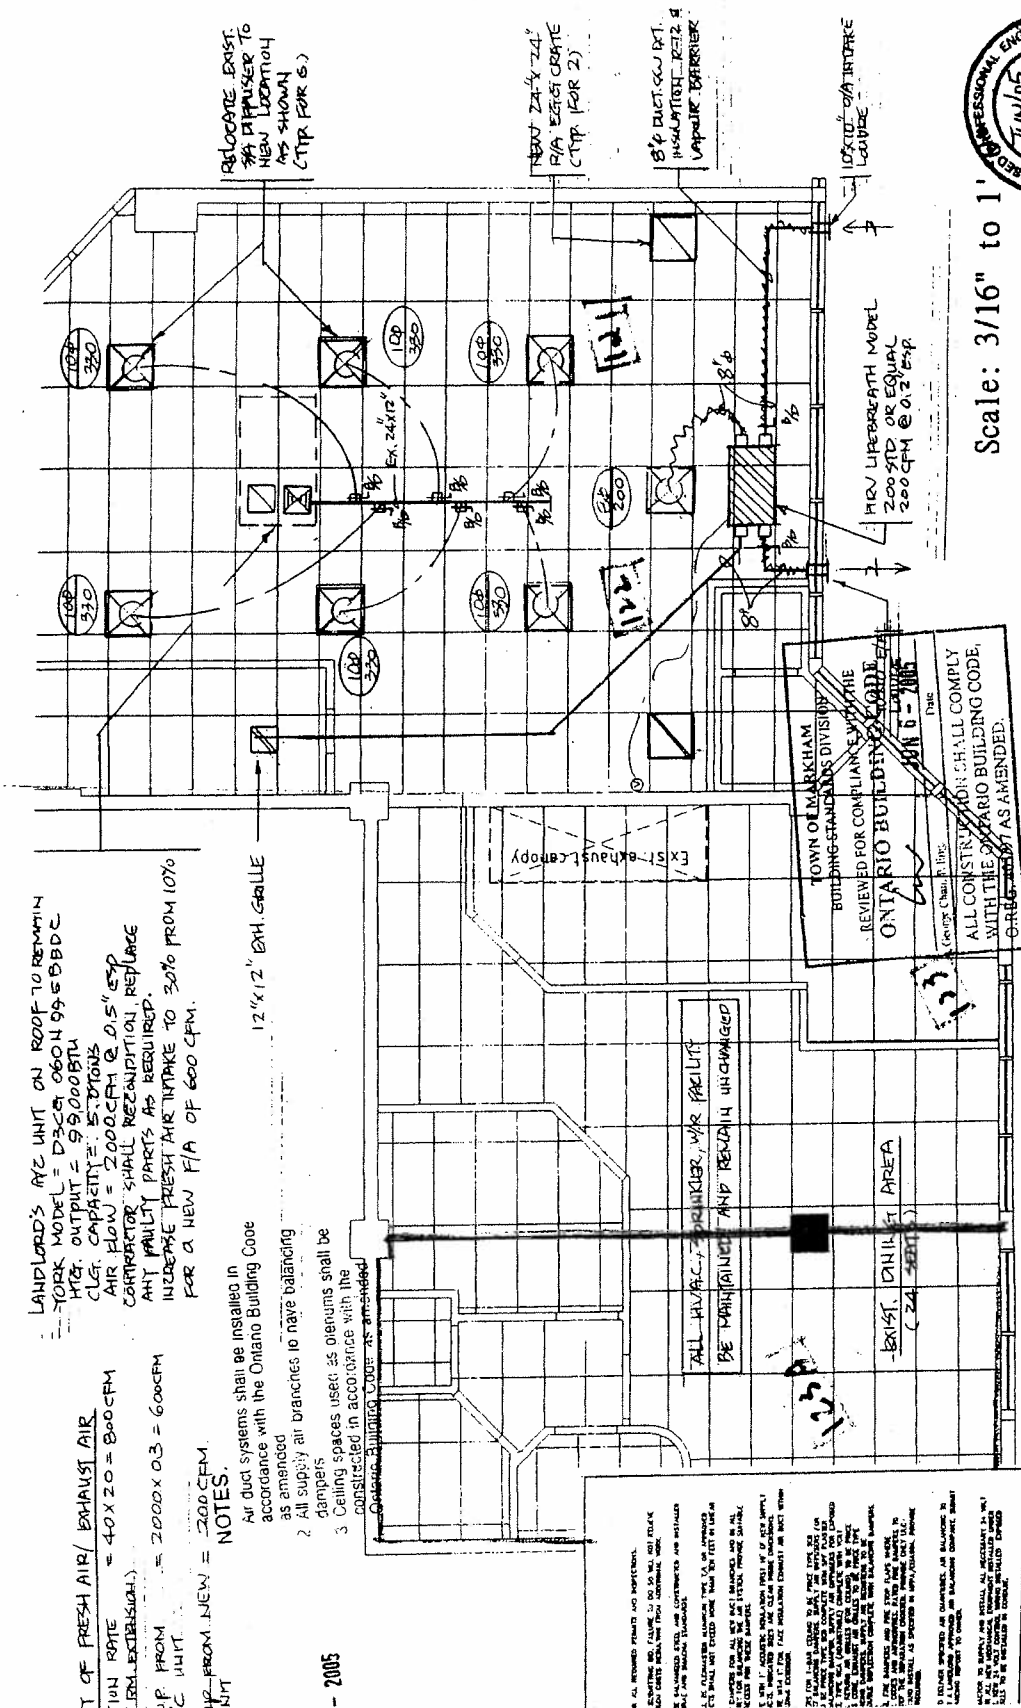

Scale: 3/16" to 1'



Notes:
 Ring cannot be scaled, all dimension must check
 if on site

Project:
 Sushu Inc.
 Unit 121, 122, 123 & 123A
 Metro Square, Markham, On

Ref:
 Date:
 Scale: As noted
 Drawn By: Tam

Project:
 Sushu Inc.
 Unit 121, 122, 123 & 123A
 Metro Square, Markham, On

Ref:
 Date:
 Scale: As noted
 Drawn By: Tam

1. ALL DIMENSIONS SHOWN ARE TO FACE UNLESS NOTED OTHERWISE.
 2. ALL DIMENSIONS SHOWN ARE TO FACE UNLESS NOTED OTHERWISE.
Application No. 05-011370 AL
revision drawings


Sushi Hut Japanese Cuisine
Unit 121, 122 123 & 123A
Metro Square, Markham, On.

Landlord: 1501790 Ontario Inc.
Metro Square Development Corporation
79 Green Ash Court, Richmondhill, On.
Tel: 905- 940 3636


Tenant: Sushi Hut Japanese Cuisine
Owner: Kwok Mui Lau & Jin Long Chen
123, 123A Metro Square, Markham, On.
Tel: 905- 513 9889

Drawing List:-

A	Site Plan
A1	Existing Plan
A2	New Layout
A3	Equipment Plan
A4	Ceiling Plan
P1	Plumbing drain
R1	Barrier-free WC reference

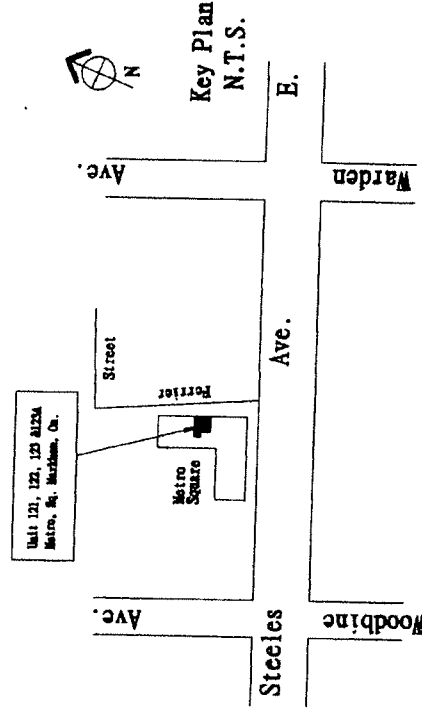

Mall

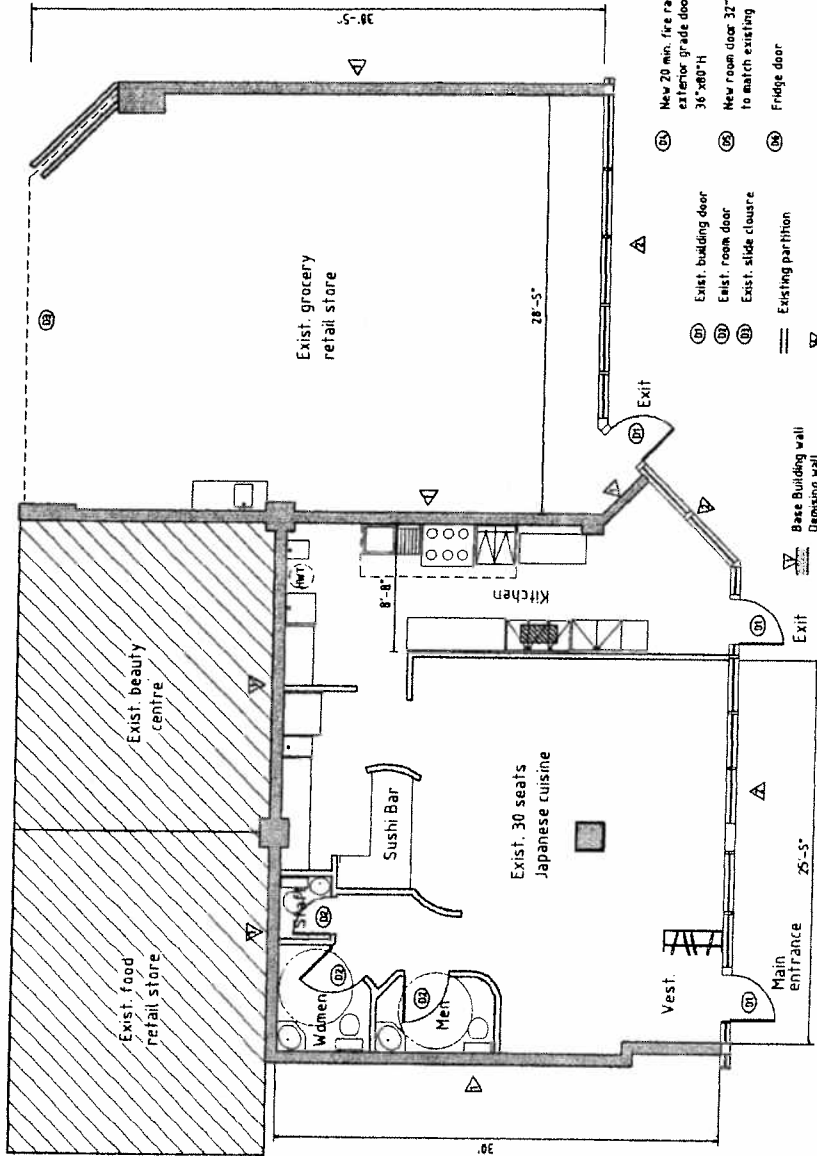

Existing Plan
Scale: 1/8" to 1'-0"

JOAN P. MENDOZA, B.A.S.C. BHALLORE
Public Health Inspector
Health Protection Division
Health Services Department
Ext. 4262

The Regional
Municipality of York
4261 Highway #7 E.
Scarborough, Ontario
M1S 1V6
Tel: 905-940-1333
Fax: 905-940-1387
Internet: www.region.york.on.ca • Email: jpm@region.york.on.ca

York Region
York Region Health Services Department
Health Protection Division

Reviewed for compliance with the
Ontario Food Premises Regulation 562/90

This approval applies only to the Food Premises
Regulations and does not include the approval
for the York Region No-Smoking By-law

Inspector Joan P. Mendoza Date MAY 24/05


Parking

General Notes:

This drawing cannot be scaled, all dimension must check
and verify on site

General Notes:	Project:	Ref:	A 1
This drawing cannot be scaled, all dimension must check and verify on site	Sushi Hat Unit 121, 122, 123 & 123A Metro Square, Markham, On	Date: Scale: As noted Drawn By: Tam	
	Tam's Design Co. 47# Tembrook Drive, Scarborough, M1V 3L8 Tel: 416-502 3788		

Mall

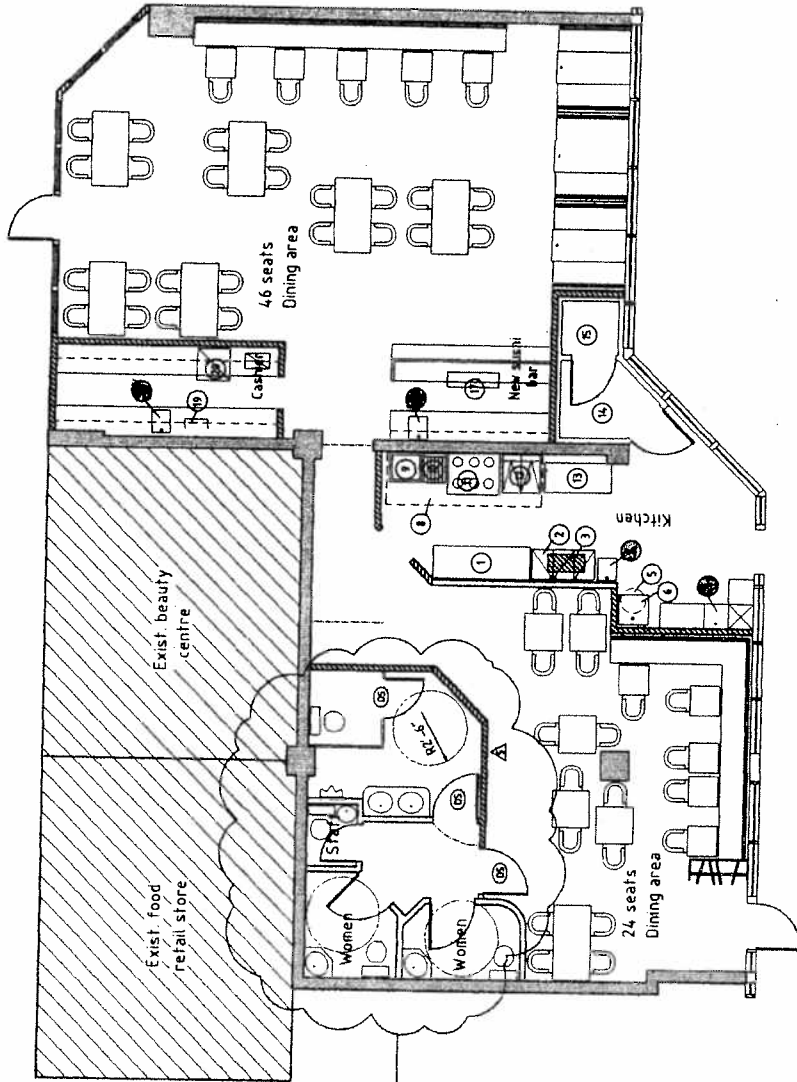

Revise the door open of Men washroom

Equipment Plan Scale: 1/8" to 1'-0"

- ① Exist. S/S table
- ② Exist. 3 comp. sink
- ③ Exist. grease trap
- ④ Relocate hand sink
- ⑤ Relocate HWT c/w suspended metal rack
- ⑥ Relocate mop sink
- ⑦ New dish wash machine & sink
- ⑧ Exist. canopy hood
- ⑨ Exist. steel plate
- ⑩ Exist. grill
- ⑪ Exist. 6 hot pot
- ⑫ Exist. 2 deep fryer
- ⑬ Exist. S/S table
- ⑭ New walk-in cooler
- ⑮ New walk-in freezer
- ⑯ New hot water dispenser
- ⑰ New sushi machine
- ⑱ Relocate wash sink
- ⑲ New hot water dispenser
- ⑳ New U/C let-maker

General Notes:

This drawing cannot be scaled, all dimension must check and verify on site

Tam's Design Co.


47# Tambrook Drive,
Scarborough, M1V 3L8
Tel: 416-502 3788

Project:
Sushi Bar
Unit 121, 122, 123 #123A
Metro Square, Markham, On

Ref:
Date:
Scale: As noted
Drawn By: Tam

A 3

Mall

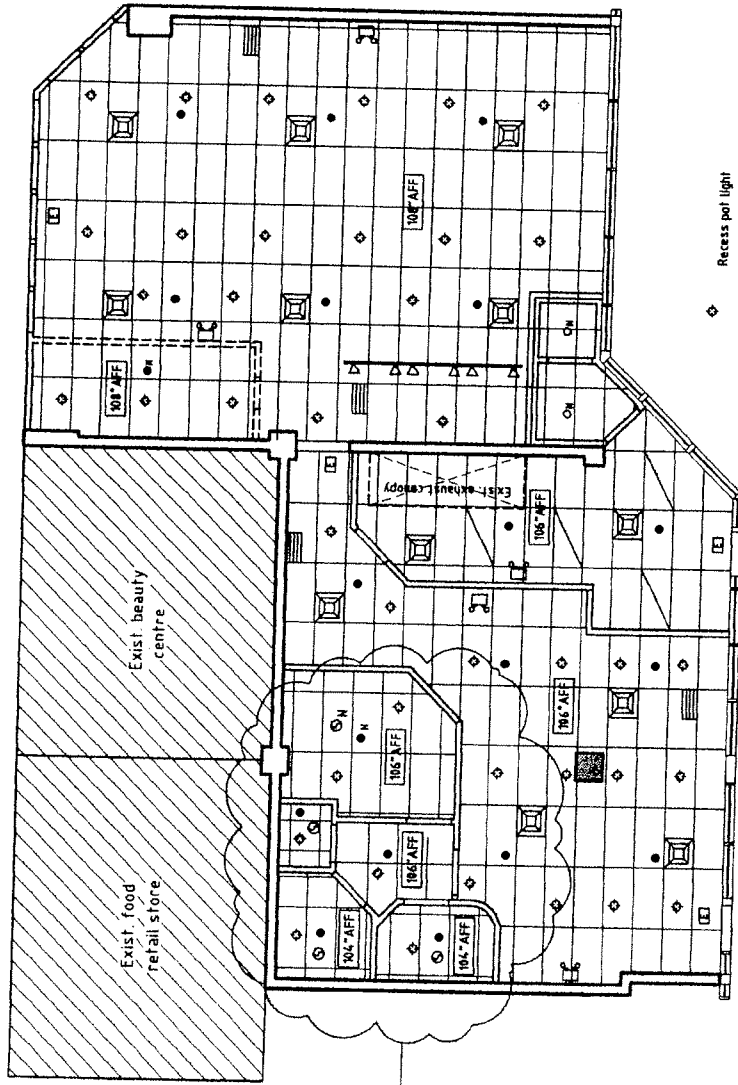

Note: Exist. HVAC system
to remain

Ceiling Plan Scale: 1/8" to 1'-0"

- Existing 2'x4' T-bar ceiling to remain otherwise as noted
- 2'x4' warm white fluorescent light box
- Existing air diffuser
- Existing air return grill
- Exist. exhaust fan
- New 198 CFM exhaust fan connect to base exhaust pipe directly to outside
- Exit light
- Recess pot light
- Track light
- Emergency light
- Existing sprinkler head
- New sprinkler head
- New dry sprinkler head for new walk-in cooler and freezer

General Notes:


This drawing cannot be scaled, all dimensions must check and verify on site

Tam's Design Co.
47# Tambrook Drive,
Scarborough, M1V 3L8
Tel: 416-502 3788

Project:
Sushi Bar
Unit 121, 122, 123 #123A
Metro Square, Markham, On

Ref:
Date:
Scale: As noted
Drawn By: Tam

A 4

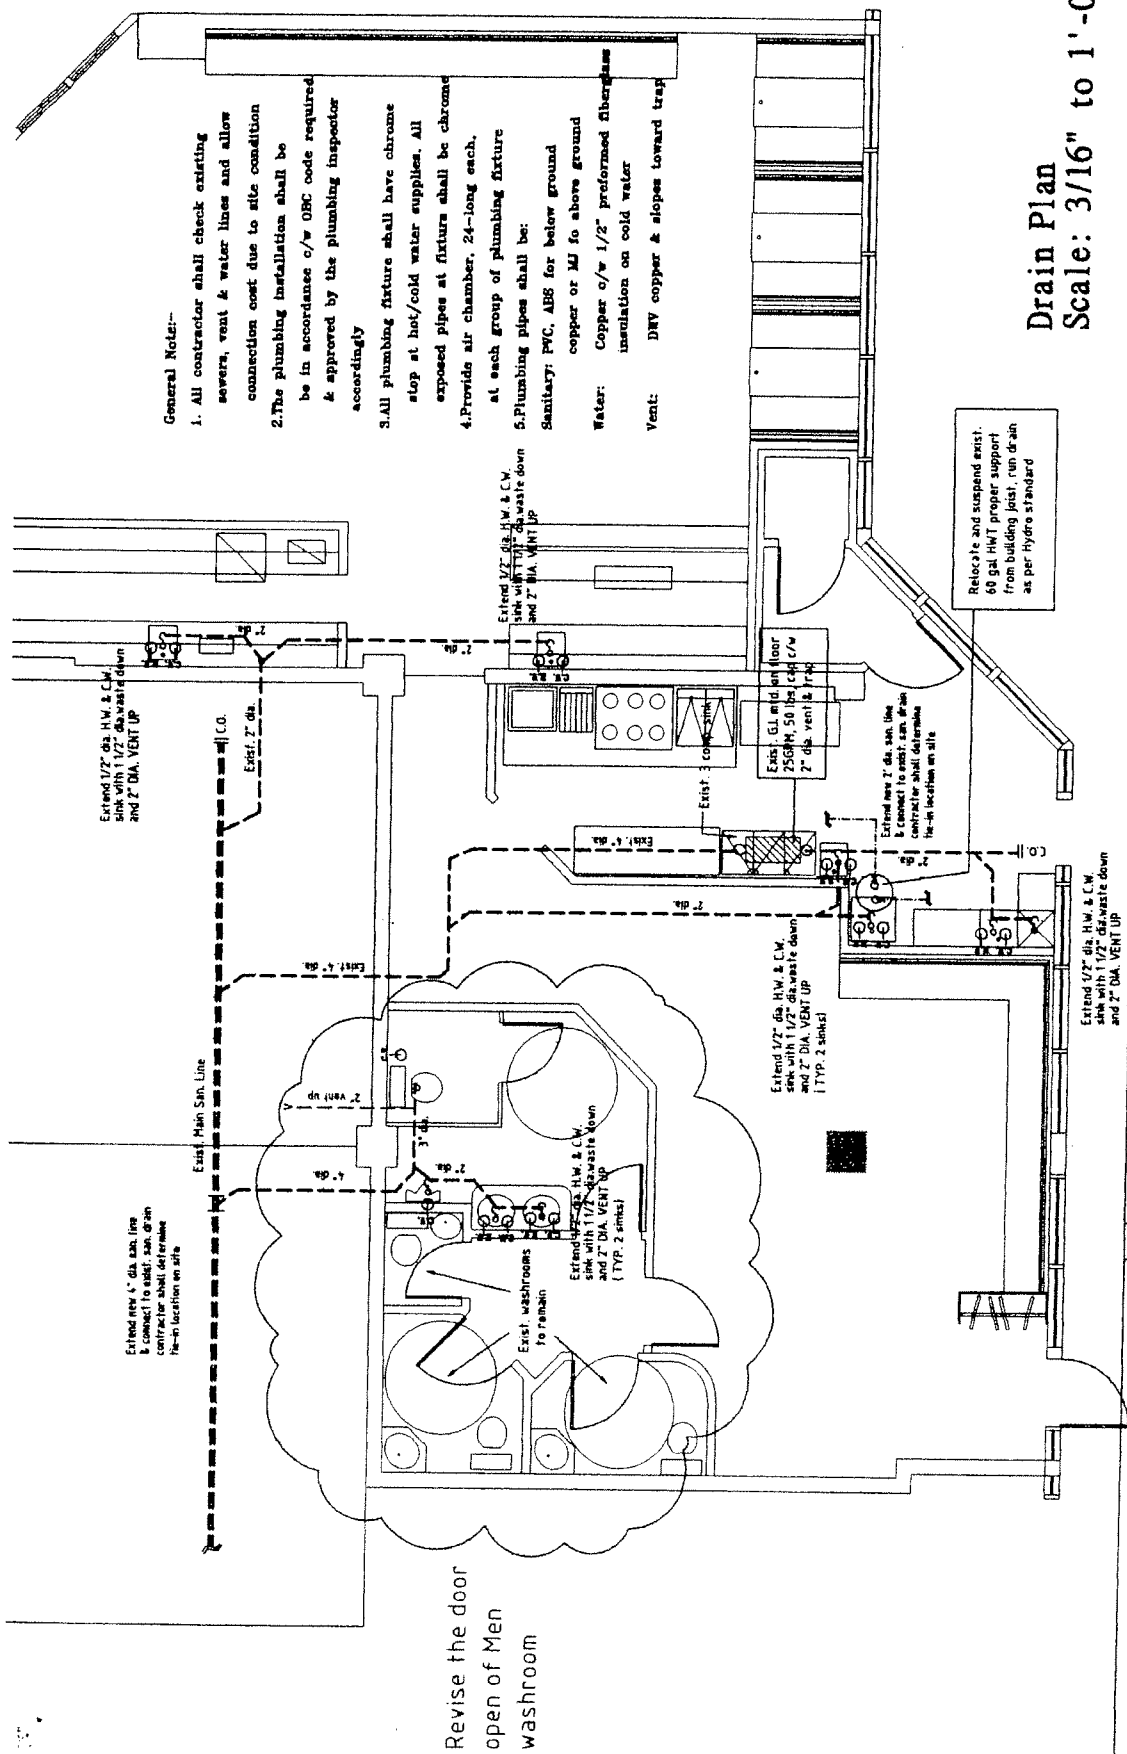

General Note:-

1. All contractor shall check existing sewers, vent & water lines and allow connection cost due to site condition
2. The plumbing installation shall be in accordance c/w OBC code required & approved by the plumbing inspector accordingly
3. All plumbing fixture shall have chrome stop at hot/cold water supplies. All exposed pipes at fixtures shall be chrome
4. Provide air chamber, 24"-long each, at each group of plumbing fixture
5. Plumbing pipes shall be:
 - Sanitary: PVC, ABS for below ground
 - copper or MJ for above ground
 - Water: Copper c/w 1/2" preformed fiberglass insulation on cold water
 - Vent: DWV copper & slopes toward trap

Drain Plan
Scale: 3/16" to 1'-0"

General Notes: This drawing cannot be scaled, all dimension must check and verify on site	Project: Sushi Bar Unit 121, 122, 123 #123A Metro Square, Marlham, On	Ref: Date: Scale: As noted Drawn By: Tam	P 1
--	---	---	-------------------

鐵板燒 (grilled)

牛扒燒

牛仔骨燒

牛舌燒

燒魚

燒三文魚頭

燒三文魚腩

照燒雞扒

金針菇肉卷

蘆笋肉卷

大蔥肉卷

香蔥豬頸肉

牛油玉米燒

魷魚魚師燒

鐵鍋餃子

日式蛋黃醬炒蝦仁

炭火串燒 (B.B.Q.)

砂肝串燒

雞心肝串燒

地雞串燒

豚肉咖喱串燒

雞皮串燒

雞翼串燒

魚丸串燒

香腸燒

魷魚麥燒

蘆笋素燒

鹽焗雞

不二屋特色冷盤

Fujiya Specials

生牛肉刺身

beef sashimi

生豆腐皮卷

namayuba roll

生春卷

spring roll

唐揚場 (deep fried)

野菜天婦羅

tempura vegetables

大蝦天婦羅

tempura shrimp

天婦羅拼盤

tempura mixed

揚出豆腐

deep fried tofu

唐揚生蚝

deep fried oyster

唐揚多春魚

deep fried small fish

唐揚魷魚圈

deep fried squid ring

唐揚雞塊

deep fried crispy chicken

唐揚裹芋

deep fried taro

炸番茄

tempura sweet potato

炸豬扒

deep fried pork chop

油淋鷄

Japanese style fried chicken

(boneless)

shrimp spring roll

海老春卷

grilled miso eggplant with meat

茄子肉味會

炒鍋

枝豆

green soybeans

鐵板炒野菜

fried mixed vegetables

衝繩炒苦瓜

stir fried bitter melon with egg

牛肉角燒

roast beef

韓式煎餅

Korean style pan cake

韓式炒米

Korean style fried vermicelli

五目脆香面

fried noodle with squid & vegetable

和風炒米

Japanese style fried vermicelli

和風冷面

kumamoto cold noodle

和風冷面

kumamoto special cold noodle

海鮮湯烏冬 (辣)

seafood udon in soup

燒雞湯烏冬 (辣)

grill chicken udon in soup

牛肉湯烏冬 (辣)

beef udon in soup

炸豬扒湯烏冬

deep fried pork chop udon in soup

野菜炒烏冬

mixed vegetables fried udon

海鮮拉麵

seafood ramen

不二屋拉麵

fujiya ramen

蛋包飯

omelette rice

蛋包飯

omelette set

香蒜炒飯

garlic minced meat fried rice

紀州梅炒飯

sourume (plum) fried rice

鰻魚飯

BBQ eel on rice

豬扒飯

deep fried pork chop on rice

食物珍貴, 請勿浪費

剩餘食物, 將按正價收費

Please do not waste food, all the wasted food will be charged

為縮短輪候時間 每桌限時 1 5 / 1 時

Price List

Adult	Lunch 午餐 (not serving sashimi)	Dinner 晚餐
成人	\$ 11.99	\$ 18.99
Senior (aged above 65)	\$ 9.99	\$ 15.99
Kids (age below 9)	\$ 7.99	\$ 13.99
小童 (9歲以下)		
Friday, Saturday, Sunday and Public holidays. \$2 surcharge for each person. 星期五、六、日及公眾假期每位另收二元。		

刺身 (sashimi)

- 三文魚 salmon
- 鯖魚 saba
- 立魚 snapper

- 白吞拿 white tuna
- 北極貝 artich surf clam
- 象牙貝 ivory clam
- 玉子 egg
- 蟹柳 crab

壽司 (sushi)

- 三文魚 salmon
- 白吞拿 white tuna
- 立魚 snapper
- 鯖魚 saba
- 蟹柳 crab

- 花之戀 salmon & roe salad
- 蟹子沙律 crab roe salad
- 飛魚子 tobiko
- 北極貝 artich surf clam
- 鰻魚 eel
- 甜蝦 sweet shrimp

加州手卷

- 三文魚手卷(咸辣)
- 三文魚皮手卷(咸辣)
- 鰻魚手卷
- 白吞拿手卷(咸辣)
- 蟹柳青瓜手卷
- 牛油果手卷
- 帶子手卷
- 辣味脆香手卷
- 天婦羅蝦手卷

加州卷

- 彩虹卷
- 帶子卷
- 黑龍卷
- 金龍卷
- 鰻魚卷
- 蟹柳卷
- 吞拿香葱卷
- 三文魚皮卷
- 辣味脆香卷
- 香芋卷
- 炸番薯卷
- 軟殼蟹卷
- 燒三文魚卷
- 烟三文魚卷
- 青瓜酸梅卷
- 海苔天卷
- 牛油果卷

- tuna roe salad roll
- salmon skin roll
- spicy & crispy roll
- taro roll
- tempura sweet potato roll
- soft shell crab roll
- grilled salmon roll
- smoked salmon roll
- cucumber & saurume(plum) roll
- tempura shrimp roll
- avocado roll

california hand roll

- salmon hand roll (spicy)
- salmon skin hand roll (spicy)
- eel hand roll
- white tuna hand roll (spicy)
- crab & cucumber hand roll
- avocado & cucumber hand roll
- scallop hand roll
- spicy crispy hand roll
- tempura shrimp hand roll

california roll

- rainbow roll
- scallop roll
- black dragon roll
- golden dragon roll
- eel roll
- crab roll

- tuna roe salad roll
- salmon skin roll
- spicy & crispy roll
- taro roll
- tempura sweet potato roll
- soft shell crab roll
- grilled salmon roll
- smoked salmon roll
- cucumber & saurume(plum) roll
- tempura shrimp roll
- avocado roll

- 番茄沙律 tomato salad
- 野菜沙律 green salad
- 蘋果沙律 apple salad
- 牛蒡沙律 gobou salad
- 海草沙律 seaweed salad
- 玉米蟹柳沙律 sweet corn & crab salad
- 韓式泡菜 kimchi salad
- 日式冷泡菜 ohidashi
- 冷豆腐 special iced tofu

湯 (soup)

- 味噌湯 miso soup
- 海鮮湯 seafood soup
- 牛筋味噌湯 beef tendon miso soup

飲料 (drinks)

- 凍檸檬茶 iced lemon tea
- 珍珠奶茶 milk tea with tapioca pearl
- 雪糕紅豆冰 red bean iced drink with ice cream
- 可樂 coke
- 雪碧 sprite
- 橙汁 c-plus

水果沙律 (fruit salad)

- 芒果味 mango
- 香草味 vanilla
- 紅豆味 red bean

枝豆	green soybeans	\$ 2.99
鐵板炒野菜	fried mixed vegetables	\$ 3.99
衝繩炒芭瓜	stir fried bitter melon	\$ 6.99
	with egg	\$ 6.99
牛肉角燒	roast beef	\$ 5.99
韓式煎餅	Korean style pan cake	\$ 5.99
韓式炒米	Korean style fried vermicelli	\$ 5.99
五目脆香面	fried noodle with squid & vegetables	\$ 5.99
	Japanese style fried vermicelli	\$ 5.99
和風炒米	kumamoto cold noodle	\$ 5.99
和風冷面	kumamoto special cold noodle	\$ 5.99
和風綫面	seafood udon in soup	\$ 6.99
海鮮湯烏冬 (辣)	grill chicken udon in soup	\$ 6.99
燒鰻湯烏冬 (辣)	beef udon in soup	\$ 6.99
牛肉湯烏冬 (辣)	deep fried pork chop	\$ 6.99
炸豬扒湯烏冬	udon in soup	\$ 6.99
野菜炒烏冬	mixed vegetables fried udon	\$ 6.99
海鮮拉面	seafood ramen	\$ 6.99
不二屋拉面	fujiya ramen	\$ 6.99
蛋包飯	omelette rice	\$ 4.99
蛋包面	moelette soba	\$ 4.99
香蒜炒飯	garlic minced meat fried rice	\$ 6.99
紀州梅炒飯	sourume (plum) fried rice	\$ 6.99
鰻魚飯	BBQ eel on rice	\$ 9.99
豬扒飯	deep fried pork chop on rice	\$ 6.99

A. 午餐 (lunch) \$ 5.99	
套餐A奉送 沙律及湯 (set A serve with salad and soup)	
1. 親子丼	stewed egg & chicken on rice
2. 鰻魚丼	stewed egg & B.B.Q. ell on rice
3. 豬扒丼	stewed egg & deep fried pork on rice
4. 明太子冷面	cod roe Japanese style cold noodle
5. 韓式炒米	Korean style fried vermicelli
6. 和風炒米	Japanese style fried vermicelli
7. 五目脆香面	fried noodle with squid & vegetable
B. 午餐 (lunch) \$ 6.99	
套餐B奉送 炒飯 (set B serve with fried rice)	
1. 不二屋拉面	fujiya ramen
2. 海鮮拉面	seafood ramen
3. 燒鰻湯烏冬	grilled chicken udon in soup
4. 海鮮湯烏冬	seafood udon in soup
5. 豬扒湯烏冬	deep fried pork chop udon in soup
C. 午餐 (lunch) \$ 6.99	
套餐C奉送 白飯、炒野菜、湯及沙律 (set C serve with fried mixed vegetable, steamrice, soup and salad)	
1. 照燒鰻扒	teriyaki chicken
2. 照燒牛扒	teriyaki beef steak
3. 照燒牛仔骨	teriyaki beef ribs
4. 照燒三文魚	teriyaki salmon
5. 天婦羅蝦	tempura shrimp
6. 燒牛舌	grilled OX tongue

Fujiya Japanese Restaurant

over 200 food items

905-513-9889

3636 Steels Ave. E

Unit 121-123

大都會廣場
Metto Square

憑此傳單外賣可獲

八五折

with this flyer, enjoy
15% off for any
pick-up order

任食

all you can eat			
Price List	Lunch 午餐	Dinner 晚餐	
Adult (not serving sashimi)	成人 \$ 11.99	\$ 18.99	
Senior (aged above 65)	長者 (65歲以上) \$ 9.99	\$ 15.99	
Kids (age below 9)	小童 (9歲以下) \$ 7.99	\$ 13.99	

Friday, Saturday, Sunday and Public holidays,
\$2 surcharge for each person
星期五、六、日及公眾假期每位另收二元。

三和菜 (Three Party Trays) (each party tray)

- 1. 45件拼盤 \$ 36.00
- 2. 60件拼盤 \$ 45.00
- 3. 80件拼盤 \$ 65.00
- 4. 120件拼盤 \$ 95.00

五和菜 (Five Party Trays)

5 pcs for \$3.99

- 三文魚 salmon
- 鱈魚 saba
- 立魚 snapper
- 白吞拿 white tuna
- 北極貝 artic surf clam
- 象牙貝 ivory clam

- 玉子 egg
- 蟹柳 crab

2 pcs for \$ 1.99

- 三文魚 salmon
- 白吞拿 white tuna
- 立魚 snapper
- 鱈魚 saba
- 蟹柳 crab

花之戀 salmon & roe salad

蟹子沙律 crab roe salad

飛魚子 tobiko

北極貝 artic surf clam

鱈魚 eel

sweet shrimp

四和菜 (Four Party Trays)

- 玉子
- 玉米沙律

每份 \$1.99

加州卷

彩虹卷

帶子卷

黑龍卷

金龍卷

鱈魚卷

蟹柳卷

吞拿香葱卷

三文魚皮卷

辣味脆香卷

香芋卷

炸番薯卷

軟殼蟹卷

燒三文魚卷

烟三文魚卷

青瓜酸梅卷

海老天卷

牛油果卷

牛油果脆香卷

不二屋脆香卷

2 pcs for \$ 1.99

- egg
- sweet corn salad

california roll

rainbow roll

scallop roll

black dragon roll

golden dragon roll

eel roll

crab roll

tuna roe salad roll

salmon skin roll

spicy & crispy roll

taro roll

tempura sweet potato roll

soft shell crab roll

grilled salmon roll

smoked salmon roll

cucumber &

sourume(plum) roll

crab & tempura

shrimp roll

avocado roll

avocado & srispy roll

fuijia special roll

加州手卷

california hand roll

三文魚手卷(或辣)

三文魚皮手卷(或辣)

鱈魚手卷

白吞拿手卷(或辣)

蟹柳青瓜手卷

牛油果手卷

帶子手卷

辣味脆香手卷

天婦羅蝦手卷

炭火串燒 (BBQ)

砂肝串燒

鰻心肝串燒

地雞串燒

豚肉咖喱串燒

鰻皮串燒

鰻翼串燒

魚丸串燒

香腸燒

魷魚姿燒

蘆筍素燒

鹽燒秋刀魚

串燒拼盤

mixed BBQ grilled

\$ 2.49

\$ 3.49

\$ 2.49

\$ 3.49

\$ 3.49

\$ 3.49

\$ 2.49

\$ 3.99

\$ 2.49

\$ 2.49

\$ 2.49

\$ 2.49

\$ 6.99

\$ 3.49

\$ 3.99

\$ 2.49

\$ 5.99

\$ 2.49

\$ 2.49

\$ 5.99